

City of Sydney

North Rosebery Park & Green Link

**Design Development - Access Review v2** 

8 November 2021



REPORT	REVISIONS	
Date	Version	Drawing No / Revision
4.11.21	v1	Concept Design for coordination
		2021_05-CD00_B, 2021_05-CD01_B, 2021_05-CD02_C,
		2021_05-CD03_C, 2021_05-CD04_B, 2021_05-CD05_B,
		2021_05-CD06_B, 2021_05-CD07_A and
		2021_05-CD08_A.
		dated 18/10/2021.
		Prepared by Gallagher Studio.
8.11.21	V2	Gallagher Studio + MGAC Minor comments update.

This report prepared by:

Jhoana Colorado Access Consultant

**Morris Goding Access Consulting** 



## Table of contents

1.	Executive Summary	4
2.	Introduction	5
2.1	Background	5
2.2	Objectives	6
2.3	Limitations	6
2.4	Accessibility of Design	6
2.5	Guidelines	6
2.6	Public Domain Design	7
3.	General Access Planning Considerations	8
4.	General Accessibility Considerations	9
4.1	Accessways - Linkages	10
4.2	Ground and Floor Surfaces	10
4.3	Stairways	11
4.5	Luminance Contrast	12
4.7	Fixed Furniture	13
4.8	Signage	14
5.	Conclusion	15



## 1. Executive Summary

This Access Review Report is a key element in the concept design and review of environmental factors approval process for North Rosebery Park and Green Link. It aims to provide appropriate access recommendations to the AS1428 series, Building Code of Australia (BCA), DDA Access to Premises Standards (including DDA Access Code) and ultimately the Commonwealth Disability Discrimination Act (DDA).

Morris Goding Access Consulting has prepared the Accessibility Report to provide recommendations and strategies to maximise reasonable provisions of access for people with disabilities.

This review will ensure that paths of travel, circulation areas, and relevant considerations are in line with current statutory guidelines and industry best practices, and in addition, with a higher level of accessibility and inclusiveness benchmarks set by the project.

This report should be read in conjunction with the marked plans as attached at the back of this report.



#### 2. Introduction

#### 2.1 Background

City of Sydney has engaged Morris Goding Access Consulting to provide an accessible design review of North Rosebery Park at at 15 Rosebery Avenue, Rosebery NSW and Green Link at Stedman Street corner with Confectioners Way Rosebery NSW.



Figure 1. North Rosebery Park & Green Link Location

The requirements of this investigation are to:

- Review supplied drawings of the proposed concept design;
- Provide a report that will assess the provisions of disability design of the development, and
- Recommend solutions that will ensure the design considerations are in line with the intent of the Disability Discrimination Act (DDA).



#### 2.2 Objectives

This report considers user groups who include generally members of the public. The report attempts to deliver equality, independence and functionality to people with a disability inclusive of:

- People with a mobility impairment (ambulant and wheelchair);
- People with a sensory impairment (hearing and vision); and
- People with a dexterity impairment.

This report seeks to provide recommendations to meet the intent of the Disability Discrimination Act 1992. In doing so, the report attempts to eliminate, as far as possible, discrimination against persons on the grounds of disability.

#### 2.3 Limitations

This report aims to provide access review comments holistically. It does not provide comments on detailed design issues that are commonly included in construction documentation.

#### 2.4 Accessibility of Design

The proposed design have been assessed against relevant Codes, Standards, and guidelines in order to provide reasonable access provisions for people with disabilities.

The design will be developed to ensure the principles of the DDA are upheld. Under the DDA, it is unlawful to discriminate against people with disabilities in the provision of appropriate access, where the approach or access to and within a premise, makes it impossible or unreasonably difficult for people with disabilities to make use of a particular service or amenity.

#### 2.5 Guidelines

The guidelines referenced in this report to ensure effective, appropriate and safe use by those with disabilities are:

- Federal Disability Discrimination Act (DDA);
- Disability Standards for Accessible Public Transport 2002 (DSAPT);
- Building Code of Australia (BCA);
- AS 1428.1:2009 (General Requirement for Access) (AS 1428.1);
- AS 1428.2:1992 Enhanced and Additional requirements;
- AS 1428.4.1:2009 (Tactile Ground Surface Indicators) (AS 1428.4.1);
- Universal Design Principles;
- "Everyone Can Play" Universal Playspace Guidelines.

Additional standards and guidelines are:

- Advisory Note on the streetscape, public outdoor areas, fixtures, fittings and furniture (2013).



- BCA Part D3 Access for People with a Disability (NCC);
- BCA Part H2 Public Transport (NCC).

#### 2.6 Public Domain Design

Ensure the design of the new public domain areas provides a consistent accessible environment through the detail design and planning of integrated accessible network of paths of travel. This will include the provision of appropriate continuous accessible paths of travel, circulation areas, way finding signage, lighting, seating, handrails, stair, ramps, lift, accessible services and amenities, and accessible pedestrian linkages.



### 3. General Access Planning Considerations

The Disability Discrimination Act 1992 (DDA) is a legislative law that protects the rights of all people. The Act makes disability discrimination unlawful and promotes equal rights, equal opportunity and equal access for people with disabilities. The Australian Human Right Commission is the governing body who control and enforce DDA compliance.

Nevertheless, building elements and external areas that provide insufficient accessible provisions for people with disabilities remain subject to the DDA. Any improvement in these areas aiming to meet current access requirements will mitigate the risk of a DDA complaint made against the building owner.

Since 1st May 2011, the Commonwealth's Disability (Access to Premises – Buildings) Standards 2010 (DDA Premises Standards) apply to all new building works and to affected parts of existing buildings.

The DDA Premises Standards' requirements (DDA Access Code) are mirrored in the access provisions of the BCA. New building work and affected parts must comply with the DDA Premises Standards and AS1428.1-2009 in the same manner as they would comply with the BCA by meeting deemed-to-satisfy provisions or by adopting an alternative solution that achieves the relevant performance requirements.

By utilising AS 1428 suite of Standards, the overall aim is to provide continuous accessible paths of travel to connect the proposed development to and through public domain areas and between associated accessible buildings in accordance with the DDA Access Code.

MGAC supports the use and consideration of universal design (UD) principles into the design to maximise access for all people. We will assist the design team to incorporate UD principles where possible within the project, while still meeting mandatory compliance requirements.

Universal design principles consider the needs of a broad range of people including older people, families with children and pushing prams, people from other cultures and language groups, visitors in transit and people with disability. By considering the diversity of users, the design will embed access into and within it, so that benefits can be maximised, without adding on specialised 'accessible' features that can be costly, visually unappealing and may perpetuate exclusion and potential stigma.

The seven key Universal design principles to consider in the on-going design include:

Principle 1: Equitable Use

Principle 2: Flexibility in Use

Principle 3: Simple and Intuitive Use

Principle 4: Perceptible Information

Principle 5: Tolerance for Error

Principle 6: Low Physical Effort

Principle 7: Size and Space for Approach and use



## 4. General Accessibility Considerations

This following is considered for North Rosebery Park and Green Link:

- The site is generally level, there are no major level changes across both sites.
- Paths generally, including path width, path circulation, turning space considerations, gradients and crossfalls.
- The ground surface generally including the smooth transition between two surfaces, grates and tree pits along paths of travel.
- Stair generally, including requirements for handrails on both sides in accordance with AS1428.1.
- Luminance contrast generally.



#### 4.1 Accessways - Linkages

The continuous accessible path of travel (CAPT) is to be designed and constructed in accordance with the following standards:

BCA part D3 (Access for people with a disability) and H2 (Public Transport Buildings);

AS 1428.1:2009 (Design for access and mobility, Part 1: General requirements for access - New building work);

AS 1428.2:1992 (Design for access and mobility - Enhanced and additional requirements - Buildings and facilities) and

DSAPT:2002 (Disability Standards for Accessible Public Transport 2002).

The following is recommended for the continuous accessible paths of travel (CAPT) and circulation requirements for the use of persons with disabilities:

- A continuous accessible path of travel should be the most commonly used and direct path of travel.
- All areas are required to be accessible to and within the North Rosebery Park and Green Link.
- Ensure minimum 1200mm clear path width is provided clear of obstacles and fixtures throughout. Generally, and if applicable, where paths are less than 1800mm wide, consider passing areas at every 6 metres (Clause 6.5 of AS 1428.2, DSAPT).

On one side of the path – 1600 L x 1800 W.

On both sides of path – 2000 L x 1800 W.

- Where a wheelchair requires to make a 90 degrees angle turn, provided 1500 x 1500mm turning space.
- Hardstand paths of travel to be provided to all unique experiences within the playground for wheelchair users.
- 1-meter minimum circulations are to be provide to achieve circulations thought the playground.

#### Comments:

Ensure all pathways provide 1200mm min. clear width in accordance with Clause 6.5 of AS 1428.2, DSAPT.

Crushed sandstone floor finish surface is to be compacted, firm/hard and a stable surface to be able to be trafficable by a person with a pram (pram parking) and a wheelchair user.

Refer marked plans for further information.

#### 4.2 Ground and Floor Surfaces

The following should be considered:



- Ground and floor surfaces generally, to be designed and constructed in accordance with AS1428.1 (2009), AS 1428.2 (1992) and DSAPT.
- Ensure slip resistant floor surfaces that are traversable by a wheelchair or walking frame as per AS 1428.1 (2009) Clause 7 with no more than 3-5mm abutment of ground surface transitions.
- Drainage grates on accessible path of travel have openings no more than 13mm wide x 150mm long, with greater dimension transverse to main direction of travel to assist wheelchair users per AS 1428.1 (2009) Clause 7.5.

#### Comments:

Ensure smooth material level transitions are provided for all floor finishes to ensure compliance with AS 1428.1:2009 (Clause 7.2).

When level difference occurs, ensure cross falls are 1:40 max. gradient.

On the basis of the current level of detail all access requirements appear capable of achieving compliance. Further work will be required during design development stage to ensure appropriate outcomes are achieved.

#### 4.3 Stairways

The AS 1428.1, and AS 1428.2 contain requirements for stairs for the use of persons with disabilities. These requirements can be summarised as follows but not limited to:

- Stair to have closed and opaque risers.
- Stairs handrails are to be provided on both sides in accordance with AS1428.1. Allow suitable space for handrail extensions and TGSI's to a further stage.
- Ensure 900mm min. distance from boundary line or park edges to prevent handrail intrusion into the transverse path of travel.

#### Comments:

All new stairs are to comply with AS1428.1. Allow suitable space for TGSI's and handrail extensions to be incorporated during a further stage.

Consider where possible and practicable the upgrade of existing stairs adjascent to new works for consistency.

On the basis of the current level of detail all access requirements appear capable of achieving compliance. Further work will be required during design development stage to ensure appropriate outcomes are achieved.

#### 4.4 Handrails

- We recommend handrails are provided on both sides of any new stair in accordance with AS 1428.1 (2009) Clause 10 including and not limited to:
- Circular/elliptical handrails have 30-50mm diameter, with 270 degree clear arc around top of handrail (extending for 600mm min. height) compliant with AS1428.1 fig. 29. Handrails to be installed at a consistent height between 865-1000mm height above



step nosing or FFL surface, compliant with AS1428.1 Clause 12d. NB. The specified height should allow for construction tolerance as outside of this range will be non-compliant.

#### Comments:

We recommend that handrails are provided in accordance with the requirements of AS 1428.1 (2009).

Refer marked plans for further information and location.

On the basis of the current level of detail all access requirements appear capable of achieving compliance. Further work will be required during design development stage to ensure appropriate outcomes are achieved.

#### 4.5 Luminance Contrast

Obstacles on the accessway should provide a contrast detectable to assist a person with vision impairment.

#### Comments:

- Poles, columns stanchions, bollards and fixtures to not project into an accessway and any obstacles that abut an accessway is recommended to have a minimum luminance contrast of 30% to its background. This includes any seating.
- Any edging and steps we recommend a minimum 30% contrasting nosing strip be provided to differentiate the level differences

On the basis of the current level of detail all access requirements appear capable of achieving compliance. Further work will be required during design development stage to ensure appropriate outcomes are achieved.

#### 4.6 Wheelchair Occupied Footprint


The following should be considered:

- The clear floor or ground space for a stationary wheelchair for an occupied wheelchair stated in AS 1428.1 and AS 1428.2 are:

740 x 1250 for 80th percentile

800 x 1300mm for 90th percentile.



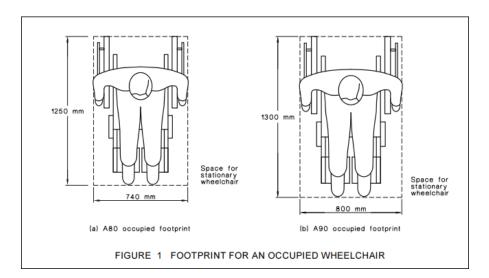

 The 80th percentile are generally adopted by AS1428.1 and the 90th percentile is adopted by AS1428.2 for enhanced and additional requirements, this applies to publicly accessible places.

#### **Comments**

As the park is within the public domain, it is recommended that the 90<sup>th</sup> percentile footprint for wheelchairs be considered in the upgrade works for inclusive design. This especially where seating is provided, consider including and incorporating the 90<sup>th</sup> percentile wheelchair footprints into the design.

- We recommend considerations for wheelchair occupied footprint to be addressed during further design developmental stages.
- Where bubblers are provided is recommended to consider 800mm x 1300mm clear space.

On the basis of the current level of detail all access requirements appear capable of achieving compliance. Further work will be required during design development stage to ensure appropriate outcomes are achieved.

#### 4.7 Fixed Furniture

Furniture is to be designed and constructed in accordance with AS 1428.2 (1992) requirements.

#### Comments

- 750 +/- 20mm AFFL for table heights.
- 640 650mm underside to tables and benches for leg clearances for wheelchair users.
- Seating height to AS 1428.2 requirements.
- Consider wheelchair footprint of 800x1300mm in any fixed furniture design.



- Litter bins should have openings at approximately 1000mm AFFL for wheelchair users.

It is understood shade/shelter will be provided by new trees located across the site.

On the basis of the current level of detail all access requirements appear capable of achieving compliance. Further work will be required during design development stage to ensure appropriate outcomes are achieved.

#### 4.8 Signage

If signage are provided, we recommend signage be in accordance with BCA Specification D3.6 and AS 1428.1 requirements.

#### **Comments**

Generally we recommend braille and tactile signage and luminance contrast to signage be considered.

On the basis of the current level of detail all access requirements appear capable of achieving compliance. Further work will be required during design development stage to ensure appropriate outcomes are achieved.




#### 5. Conclusion

MGAC has assessed the proposed scheme for the North Rosebery Park and Green Link in Rosebery NSW 2018. The proposed drawings indicate that accessibility requirements, pertaining to external site linkages and park area access can be readily achieved. However, pathways under 1200mm width are recommended to be reviewed.


It is advised that MGAC will work with the project team as the scheme progresses to ensure appropriate outcomes are achieved in building design and external domain design.

# NORTH ROSEBERY PARK & GREEN LINK

# LANDSCAPE CONCEPT DESIGN

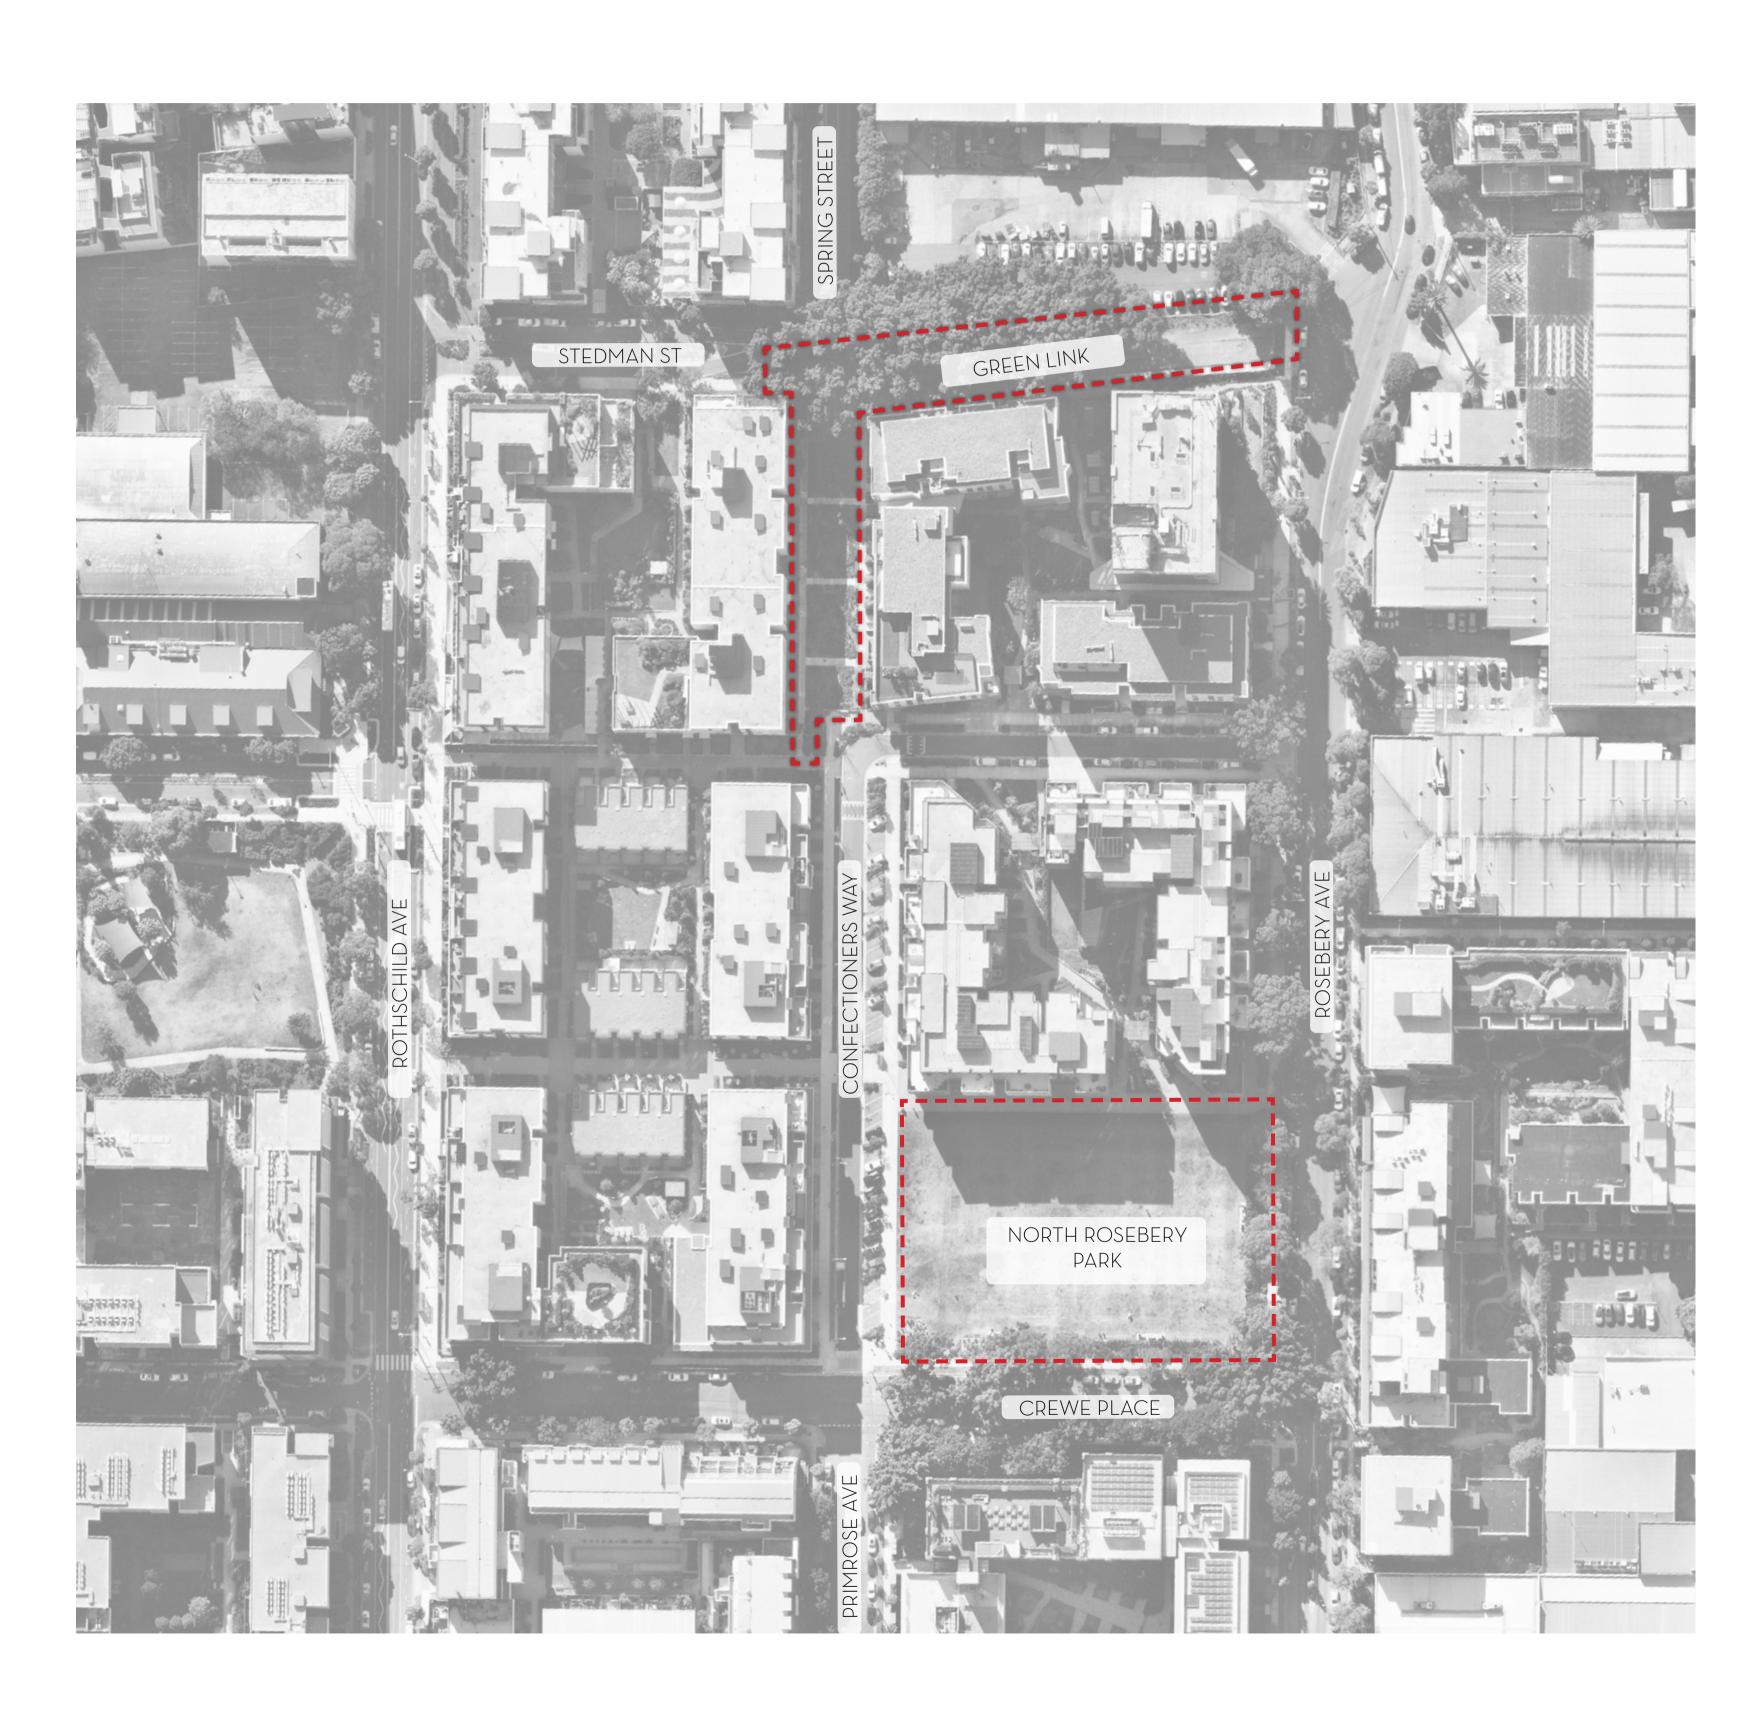


Drawing Number	Drawing Title	Scale	Revision
2021_05-CD00	COVER SHEET	NTS	В
2021_05-CD01	PROJECT BACKGROUND & DESIGN APPROACH	NTS	В
2021_05-CD02	LANDSCAPE PLAN 01 - GREEN LINK	1:200 @ A1	С
2021 <u>05</u> -CD03	LANDSCAPE SECTION AA & BB	1:100 @ A1	С
2021 <u>05</u> -CD04	LANDSCAPE PLAN O2 - PARK	1:200 @ A1	В
2021 <u>05</u> -CD05	LANDSCAPE SECTION CC	1:100 @ A1	В
2021 <u>05</u> -CD06	LANDSCAPE SECTION DD	1:100 @ A1	В
2021 <u>05</u> -CD07	PLANTING PLAN AND SCHEDULE	NTS	А
2021_05-CD08	NORTH ROSEBERY PARK PERSPECTIVE	NTS	А

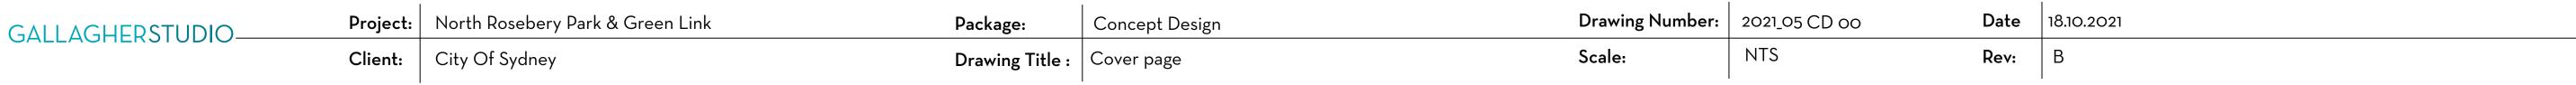

# CONTEXT & EXISTING CONDITIONS

## NEIGHBOURHOOD CONTEXT

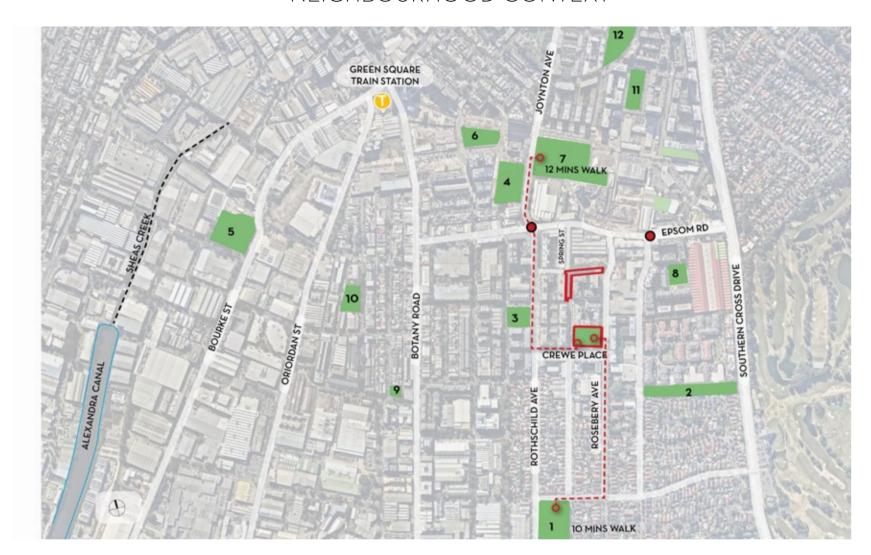


# SITE LOCATION



# EXISTING CONDITIONS




# 1: THE SAND RIDGE

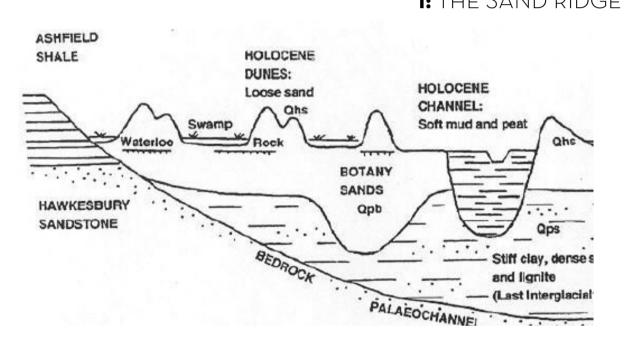

The 100,000-year-old aeolian (wind-blown) dune sand ridges would have dominated the area. This underlying dune system extends from Botany Bay in the south, north towards Sydney Harbour and east towards the Pacific Ocean. The park and green links have been designed to incorporate the natural sand and sandstone landscapes, to reflect this expansive, now largely hidden dune system.

# DESIGN APPROACH

2: MOVEMENT

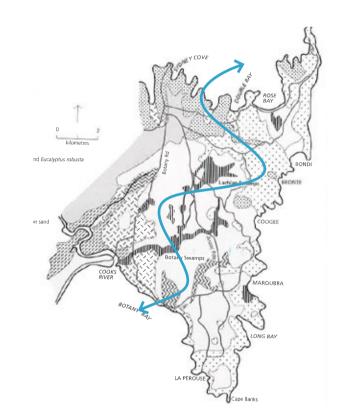

The dune ridge is a place of movement. Darug and Bidigal communities connected through this place on their way to Sydney Harbour and Botany Bay. Flowering heaths and banksias would have marked changes in seasons and rainfall. The park and link are still spaces where people pass through and meet daily. The design captures the idea of change and movement, in the design structure and in the selection of trees and plants, allowing visitors to read the


# **3:** NESTING



The precinct would have been extensively covered with Eastern Suburbs Banksia Scrub, a diverse plant community occurring on sand dominated by heath or flowering shrubs that would have been a haven for native bird life. This vegetation is an endangered ecological community in NSW has largely disappeared from this area. The design reinterprets the idea of nesting as a place for rest and respite for animals and people. The design creates a series of endemic gardens, with flowering species providing habitat for native birds. The configuration of elevated play structures, nestled in the trees and constructed with timber and rope evoke the idea of bird nests and nets. Clusters of seating within the gardens and under shade trees and provide places for shelter and protection across the park and green link.


# PARK STRUCTURE

daily and seasonal variations of this place.

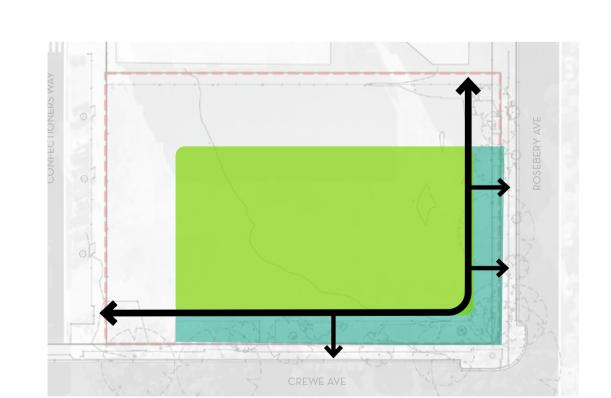


# THE LAWN & GARDEN EDGE

- The lawn provides a place of gathering and informal play.
- The street edge garden acts as an interface to the street.
- Creates a comfortable space for outlook.Emphasis on habitat plantings.

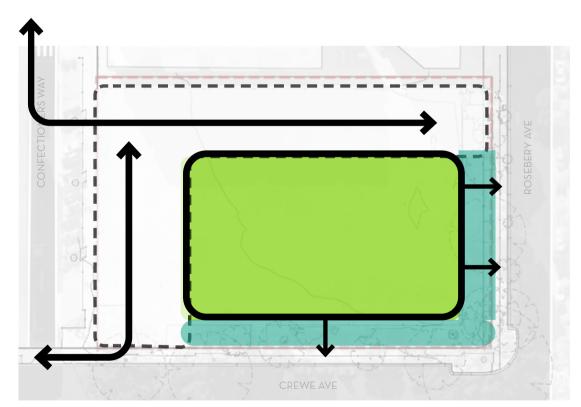


# THE RIDGE TERRACE

- Interpretation of the ridge line as a place of movement and
- Creates a threshold space between the street, apartments and park.

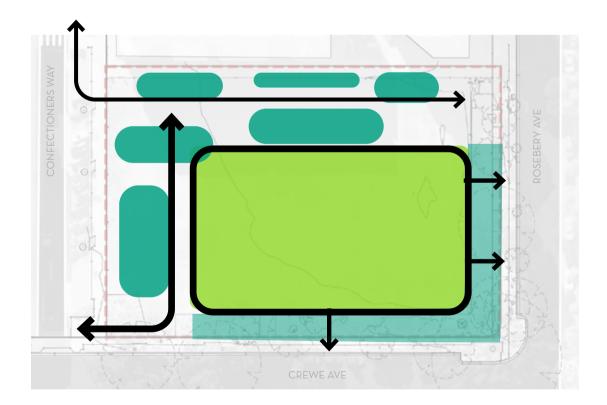


# DUNE GARDENS

- Areas of planting dispersed throughout the ridge terrace.
- Incorporating native gardens and sandstone mulch.
- Emphasis of seasonality and texture.

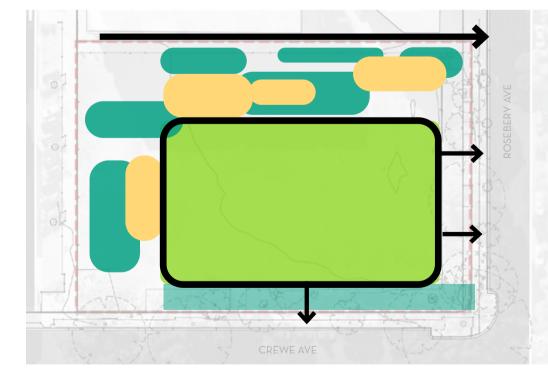

# PLAY GROVES


- Pockets of play and seating in concentrated zones, set within planting.
- Offering play elements for children of varying ages.
- Play themes of exploration, climbing, nesting, seasonality.

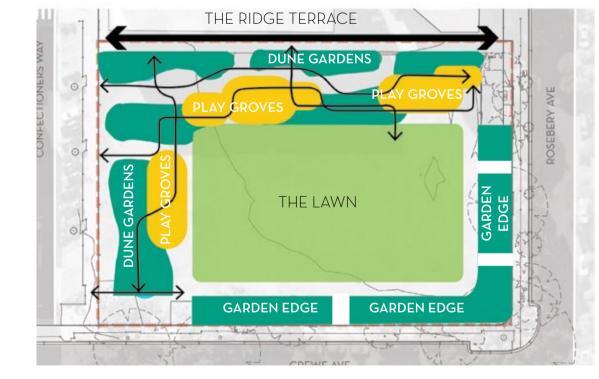


# STRUCTURE PLAN

- A combination of open lawn areas and intricate gardens and gathering spaces
- Structured for optimum microclimate benefits include shade to play areas and sun to lawn zones.
- Design speaks to the ecological character and identity of place.


	ı	ı	ı		I
GALLAGHERSTUDIO	Project: North Rosebery Park & Green Link	Package: Concept Design	Drawing Number: 2	2021_05 CD 01 Date	18.10.2021
CALLACTIERO TO DIO	Client: City Of Sydney	Drawing Title: Landscape Principles & Structure Diagrams	Scale:	NTS Rev:	В

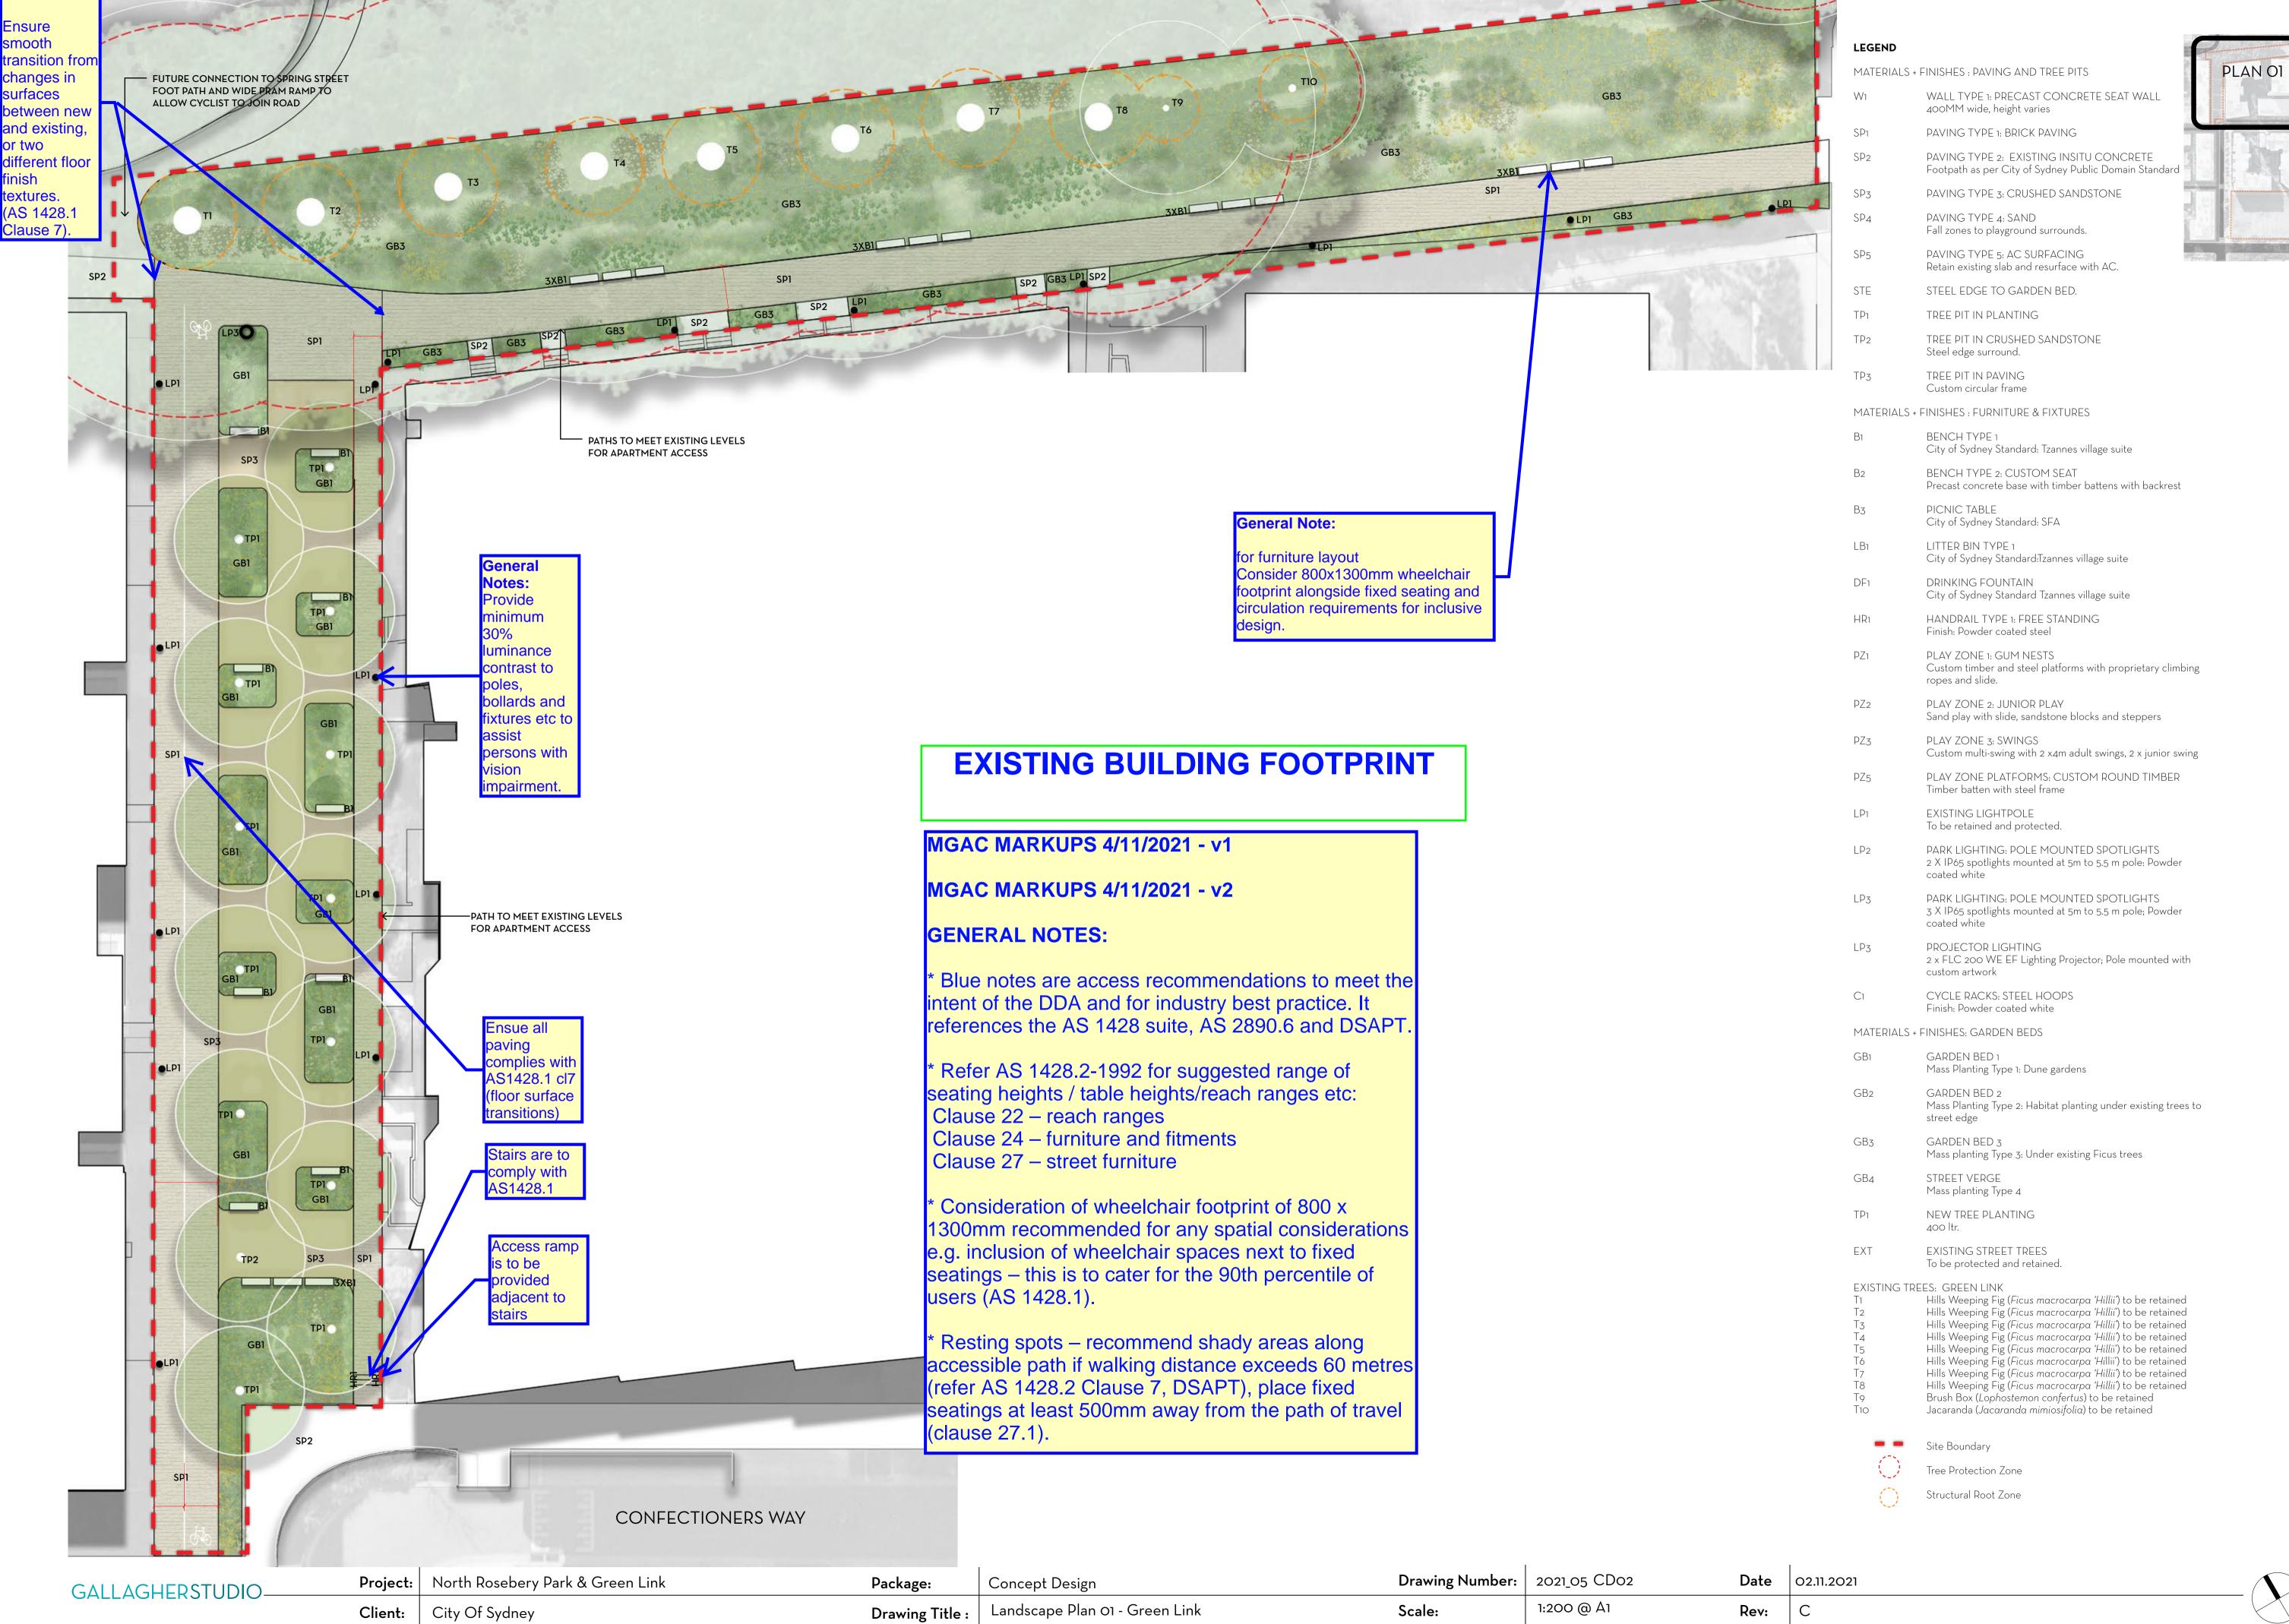



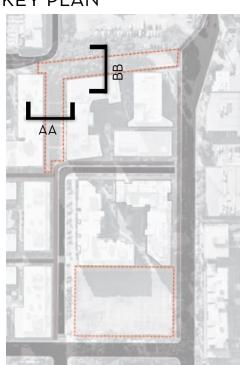



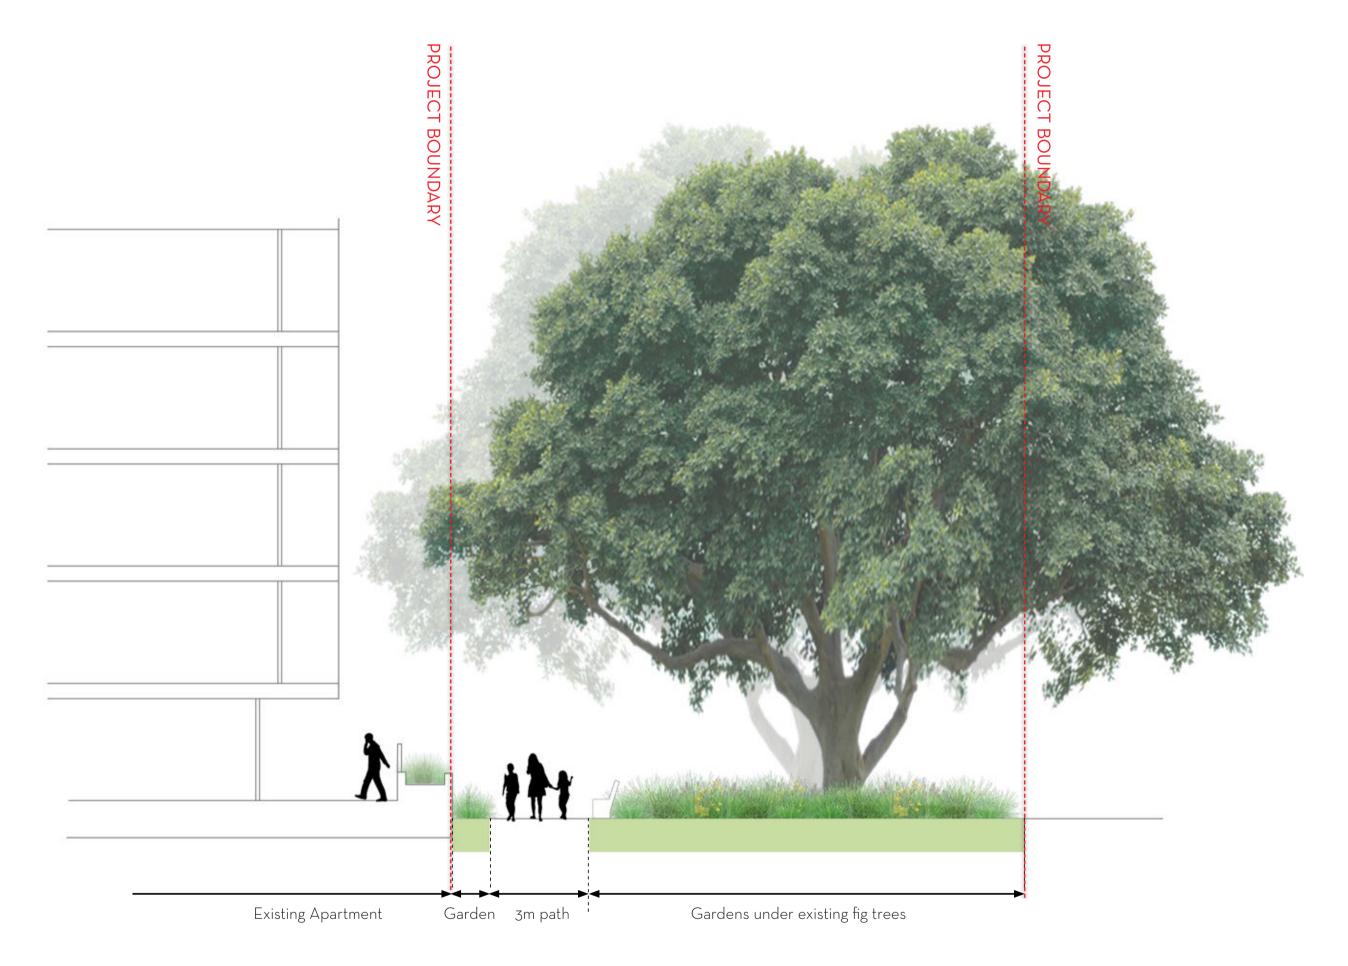


SECTION AA: GREEN LINK NORTH - SOUTH

SECTION BB: GREEN LINK EAST WEST


GALLAGHERSTUDIO	Project:	North Rosebery Park & Green Link	Package:	Concept Design	Drawing Number:	2021_05 CD 03	Date	02.11.2021	(
CALLACTIERO TO DIO	Client:	City Of Sydney	Drawing Title :	Landscape Section AA & BB	Scale:	1:100 @ A1	Rev:	С	_ (




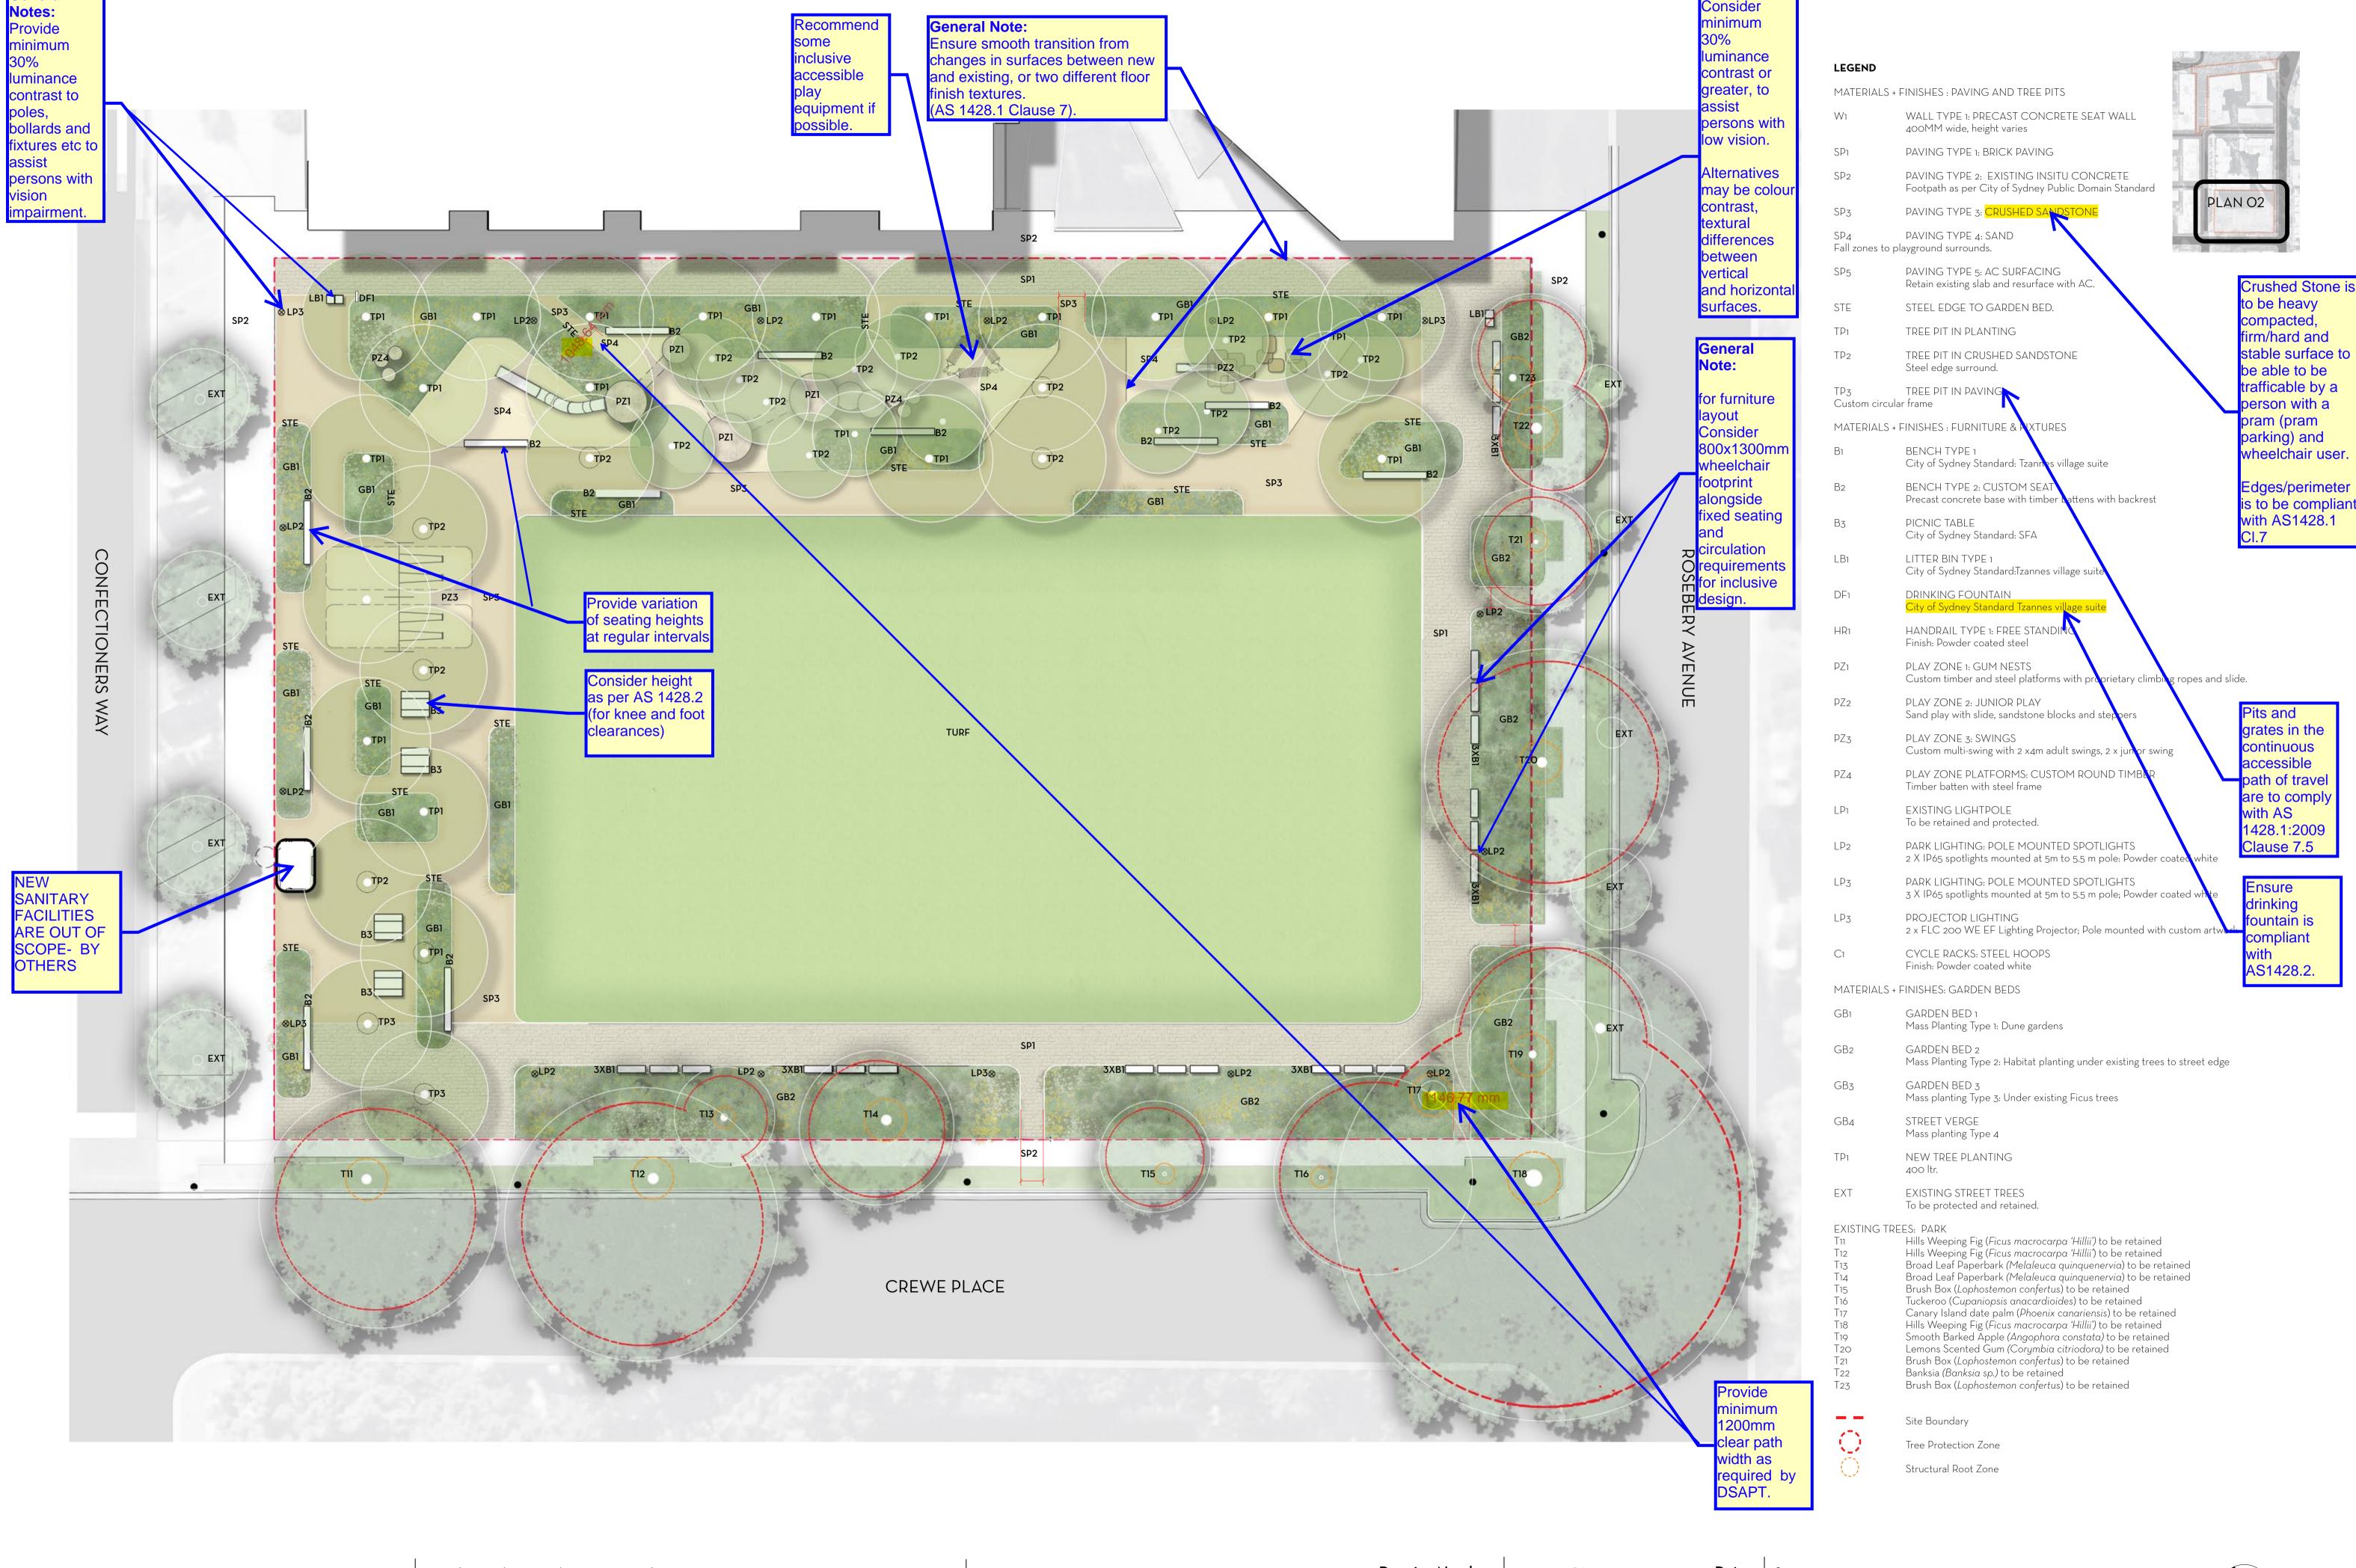






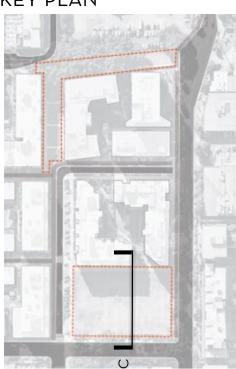

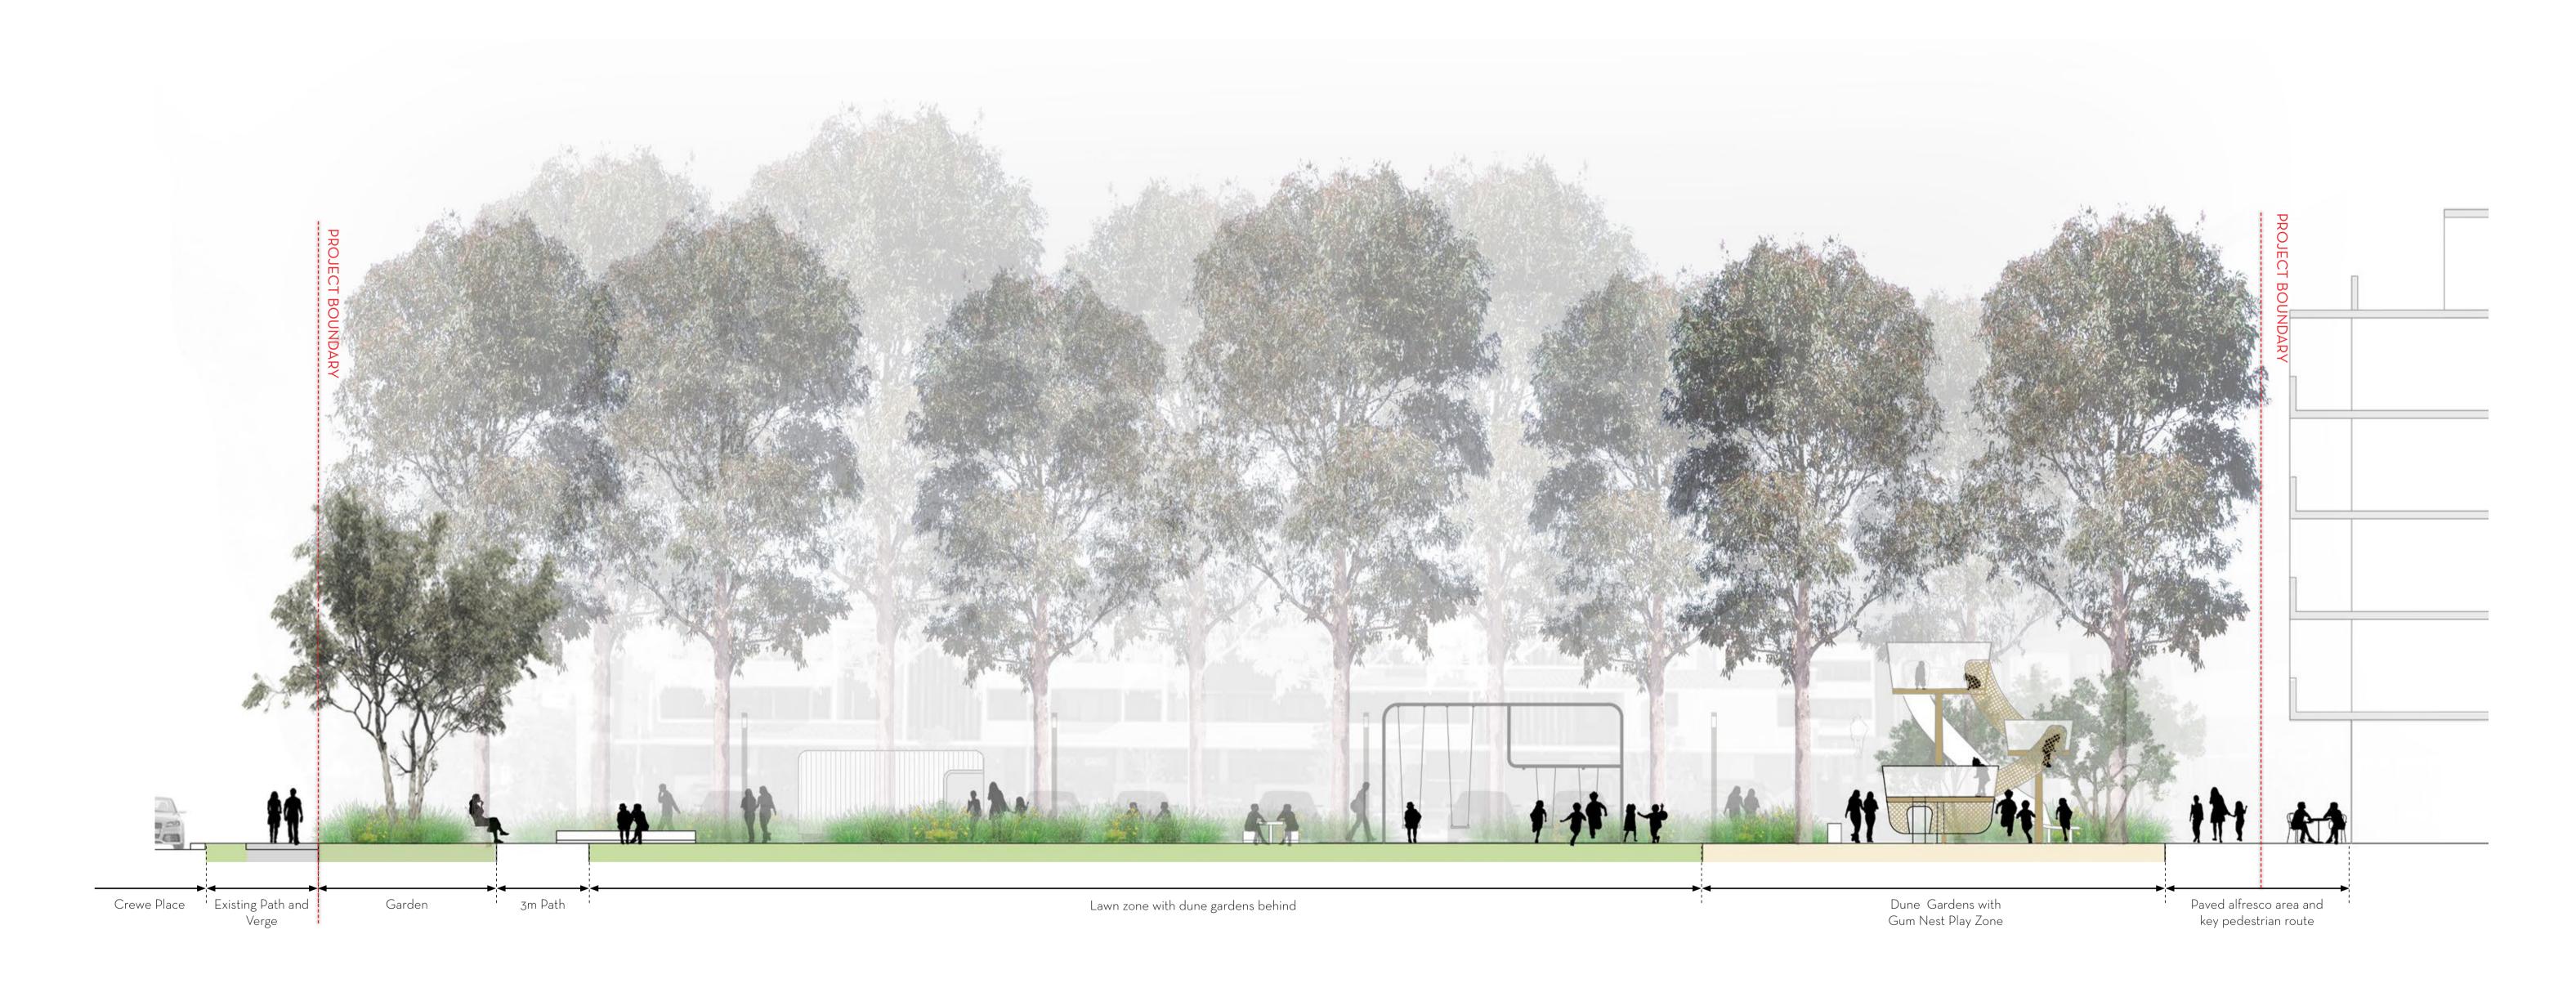


GALLAGHERSTUDIO	Project: North Rosebery Park & Green Link	Package:	Concept Design	Drawing Number:	2021_05 CD 05	Date	18.10.2021
CALLACTILICOTODIO	Client: City Of Sydney	Drawing Title :	Landscape Section CC	Scale:	1:100 @ A1	Rev:	В

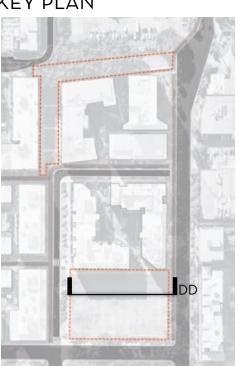



GALLAGHERSTUDIO	Project: North Rosebery Park & Green Link	Package:	Concept Design	Drawing Number	2021_05 CD 06	Date	18.10.2021
CALLACTILICOTO DI C	Client: City Of Sydney	Drawing Title :	Landscape Section DD	Scale:	1:100 @ A1	Rev:	В



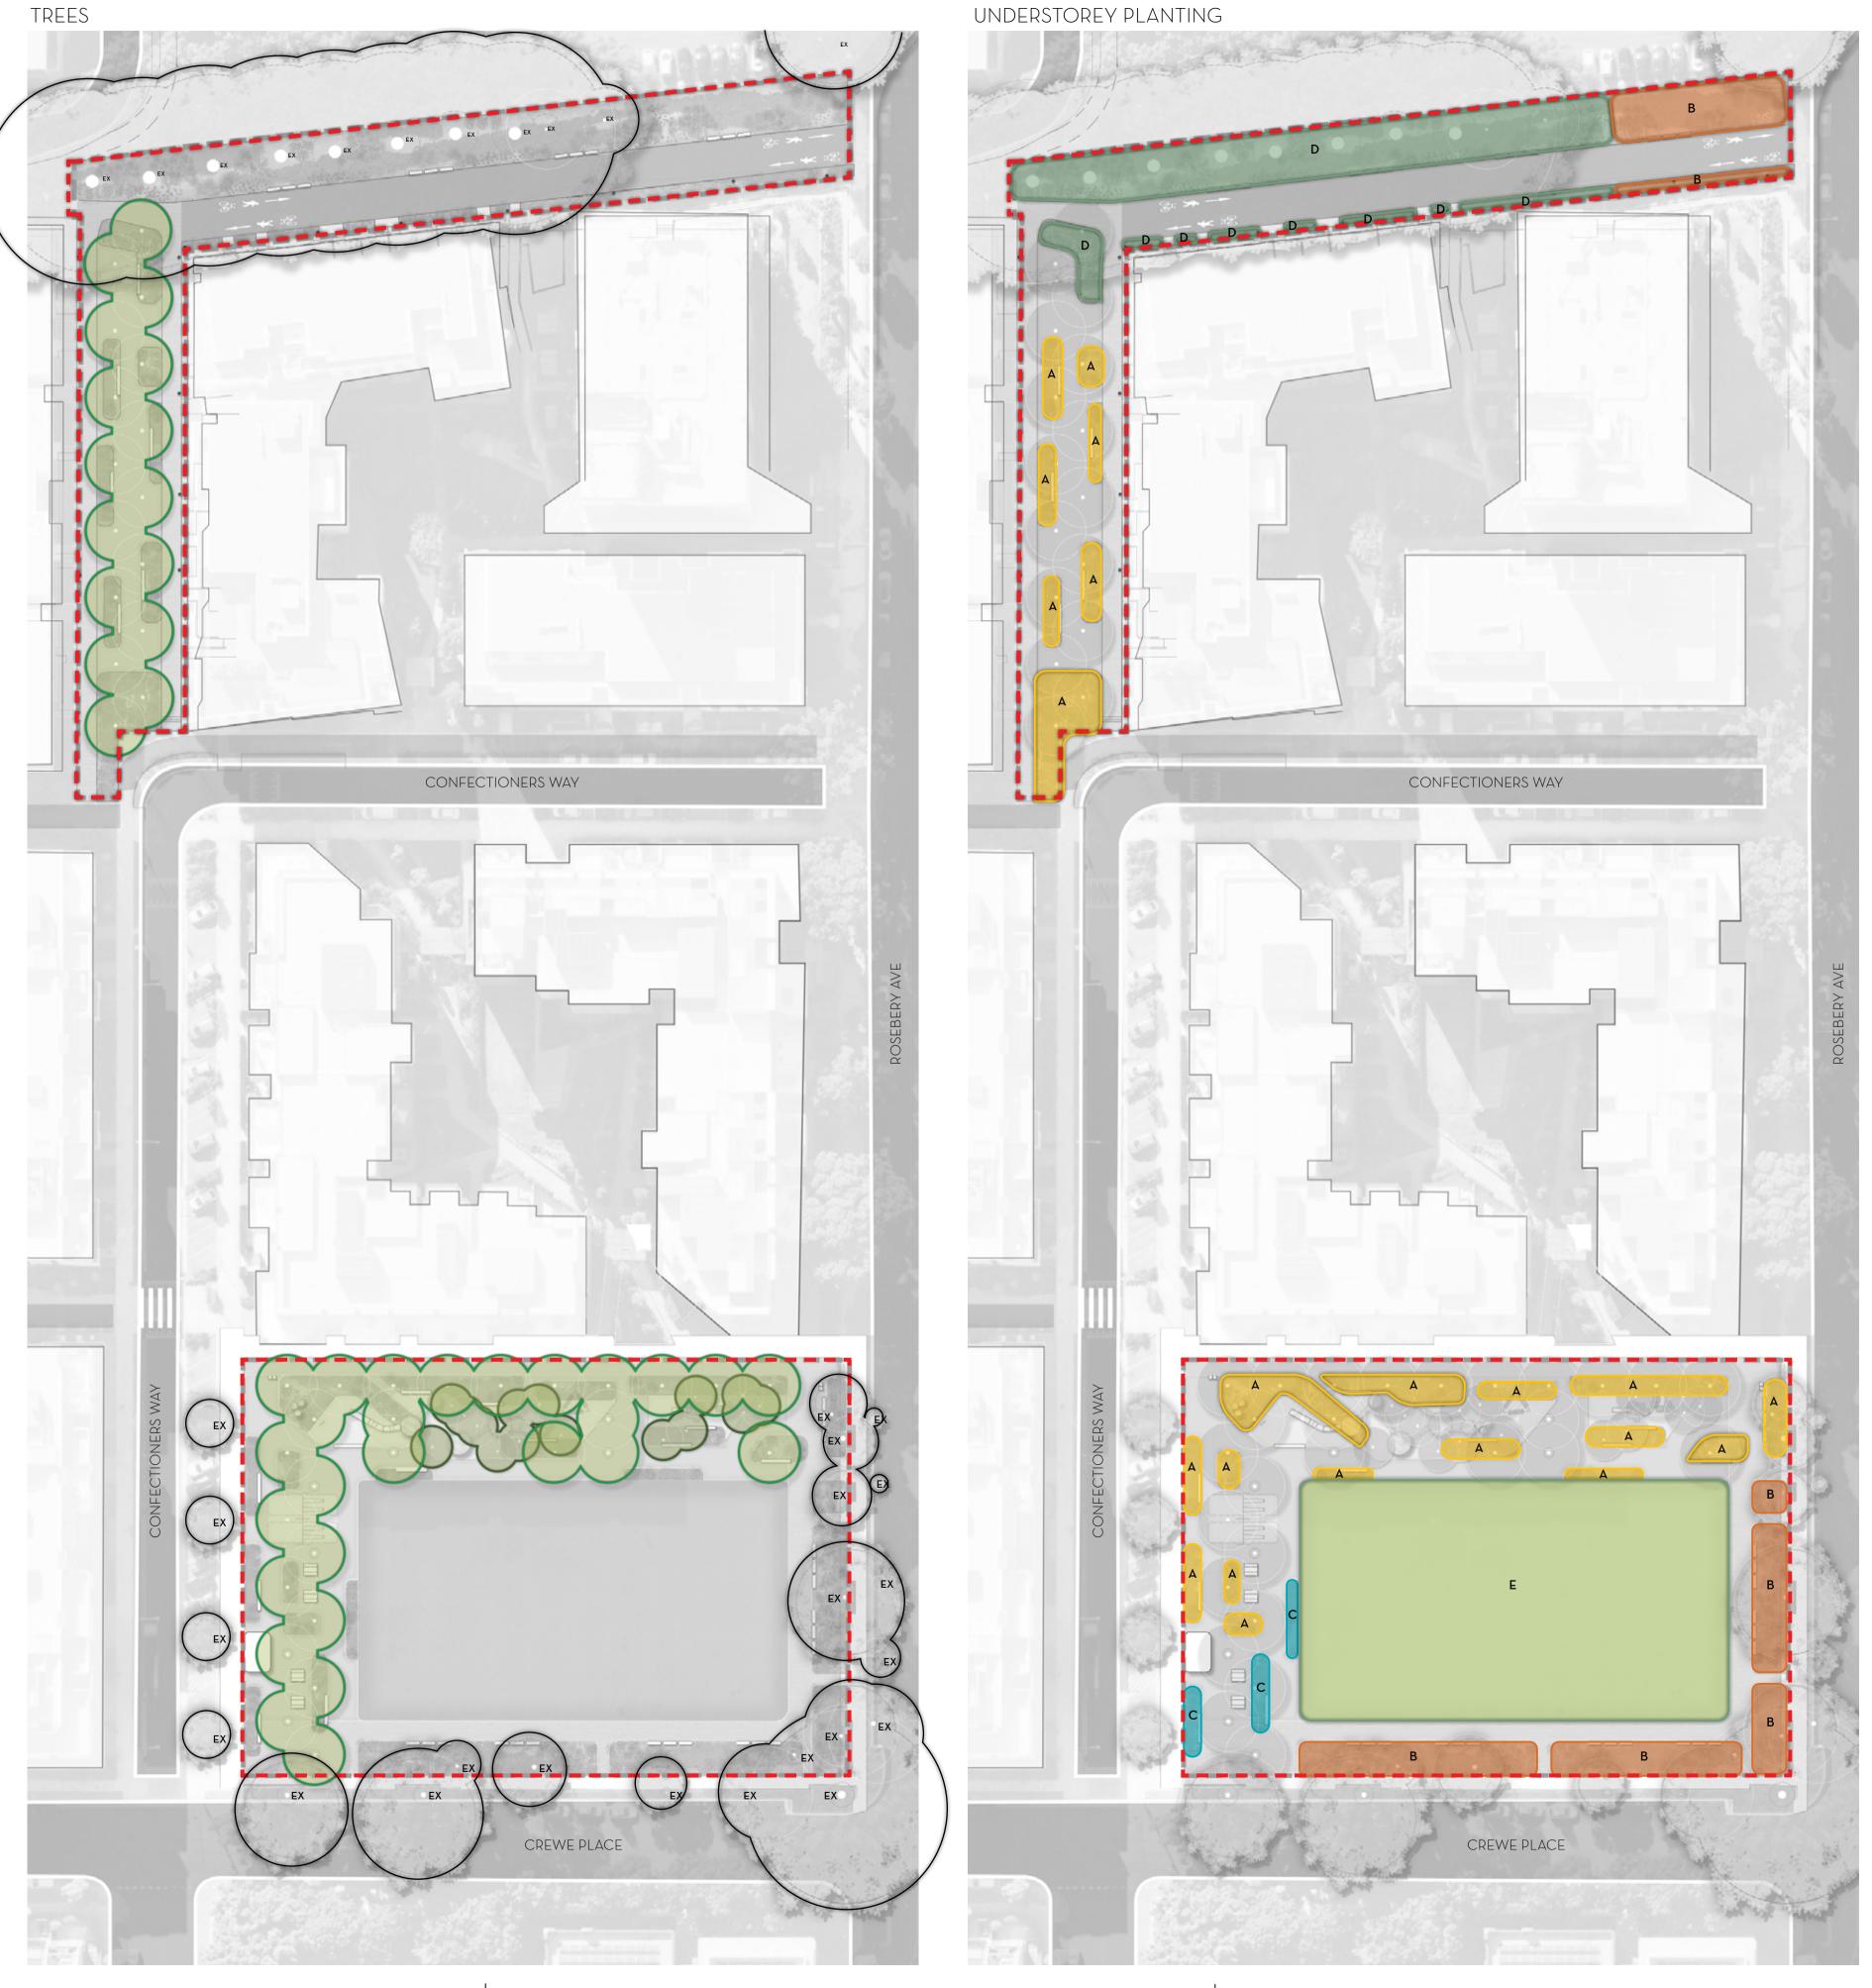

# PLANTING SCHEDULE

Code	Species	Common Name	Origin	Mature Height	Mature Spread	Location
TREES		<u> </u>	•	<u>'</u>	-1	
AC	Angophora costata	Smooth-barked Apple	Native	2Om	15m	As per plar
ВА	Banksia aemula	Wallum Banksia	Endemic	8m	2.5m	As per plar
BS	Banksia serrata	Old Man Banksia	Endemic	10m	3m	As per plar
BI	Banksia integrifolia	Coast Banksia	Endemic	6m	4m	As per plai
CG	Corymbia gummifera	Red bloodwood	Native	2Om	15m	As per pla
EM	Eucalyptus microcorys	Tallowwood	Native	30m	15m	As per pla

GROUN	ID COVERS					
Am	Actinotus minor	Lesser Flannel Flower	Endemic	400mm	400mm	А
Ah	Actinotus helianthi	Flannel Flower	Endemic	400mm	400mm	А
Bs	Billardiera scandens	Apple Berry	Endemic	500mm	2000mm	А
Вр	Boronia parviflora	Swamp Boronia	Endemic	300mm	300mm	А
Cg	Carpobrotus glaucesens	Pig face	Native	400mm	500mm	A, B
Сс	Conostylis candicans	Cotton Heads	Native	300mm	500mm	A, B
Dt	Darwinia taxifolia	prostrate form	Endemic	300mm	1000mm	А
Hs	Hibbertia scandens	Guinea Flower	Native	300mm	1200mm	A, B
Hv	Hardenbergia violacea	Happy Wanderer	Endemic	500mm	1200mm	A, B
Kr	Kennedia rubicunda	Dusky Coral Pea	Native	400mm	2000mm	A, B

STRAPP	PY LEAF/GRASSES					
Dc	Dichelachne crinita	Long hair plume grass	Endemic	800mm	600mm	А
Dr	Dianella caerulea	Flax Lily	Native	800mm	1200mm	A, B
	Dianella revoluta	Blue Flax Lily	Endemic	500mm	500mm	А
Fn	Ficinia nodosa	Knotted Club Rush	Native	600mm	600mm	С
Lt	Lomandra 'tanika'	Matt Rush Cultivar	Native	500mm	600mm	A, C
Ll	Lepidosperma laterale	variable sword sedge	Endemic			С
Rf	Restio tetraphyllus	Tassel Rush	Native	1000mm	500mm	С

SHRUBS	S					
Ас	Acacia cognata Limelight"	Dwarf River Wattle	Native	1500mm	2000mm	В
Ah	Actinotus helianthii	Flannel Flower	Endemic	700mm	500mm	A, B
An	Atriplex nummularia	Old Man Saltbush	Endemic	1500mm	750mm	A, B
Bm	Banksia marginata	Silver Banksia	Endemic	1200mm	1200mm	А
Br	Bauera rubioides	Native Bauera	Endemic	1000mm	1000mm	А
Во	Breynia oblongifolia	Coffee Bush	Endemic	2000mm	1000mm	А
Ct	Conospermum taxifolium	Variable Smoke Bush	Endemic	800mm	300mm	А
Са	Correa alba	White Correa	Endemic	1500mm	1500mm	A, B
Ea	Eriostemon australasius	Pink wax flower	Endemic	600-2000mm	1000mm	А
Gp	Grevillea parvula x juniperina prostrate	Grevillea 'Tucker Time Winter Feast	Native	500-1000mm	1500mm	В
Wf	Westringia fruitcosa	Coastal Rosemary	Native	1500mm	1500mm	D
Xr	Xanthorrhoea resinifera	Grass Tree	Native	2m	1500mm	А

GREEN	LINK PLANTING: UNDER FIG					
Аа	Asplenium australasicum	Birds Nest Fern	Native	O.5-1.5m	O.5-1.5m	D
Ас	Arthropodium cirratum	Renga Renga Lily	Exotic	1m	1000mm	D
Ај	Ajuga 'Catlins Giant'	Giant Bugle	Exotic	200mm	500mm	D
Bs	Blechnum gibbum	Silver Lady Fern	Exotic	1.2m	1000mm	D
Md	Microsorum diversifolium	Kangaroo Paw Fern	Native	300mm	600mm	D
Px	Philodendron xanadu	Xanadu Philodendron	Exotic	1500mm	1500mm	D
Ss	Spathiphyllum 'Sensation'	Peace Lily	Exotic	1000mm	1000mm	D
Sw	Spathiphyllum wallisii	Petite Peace Lily	Exotic	300mm	300mm	D
Vh	Viola hederacea	Native violet	Native	200mm	600mm	D

KEY

**EXTENT OF WORKS** 

ZONE A - DUNE GARDEN - 6 PLANTS PER 1M2

ZONE B - GARDEN EDGE - 6 PLANTS PER 1M2

ZONE C - RAIN GARDEN - 6 PLANTS PER 1M2

ZONE D - GREEN LINK SHADE PLANTING - 6 PLANTS PER 1M2

ZONE E - TURF


TREE TYPE 1 - GUM SP. 400L POTS

TREE TYPE 2 - BANKSIA SP. 200L POTS

EXISTING TREE

GALLAGHERSTUDIO———	Project:	North Rosebery Park & Green Link	Package:	Concept Design	Drawing Number:	2021_05 CD 07	Date	18.10.2021
	Client:	City Of Sydney	Drawing Title :	Planting Plan and Schedule	Scale:	NTS	Rev:	А



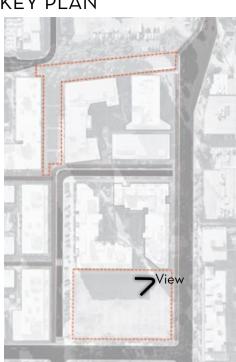



GALLAGHERSTUDIO———	Project: North Rosebery Park & Green Link	Package: Co	Concept Design	Drawing Number:	2021_05 CD 08	Date	18.10.2021
CALLACITEROTODIO	Client: City Of Sydney	Drawing Title: No	lorth Rosebery Park Perspective	Scale:	N/A	Rev:	А

